


T.2S. R.5E. W.M.

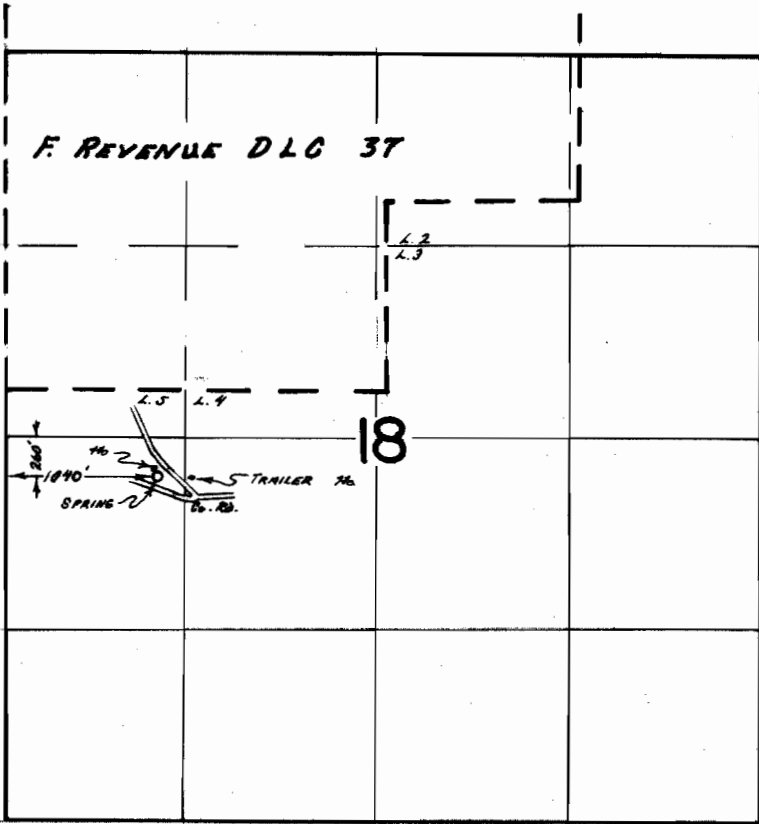

FINAL PROOF SURVEY
UNDER

Application No. 44236 Permit No. 34790
IN NAME OF

HORACIO & RUMALDA ZARATE
NOAH H. & FRANCIS N. TOATES
Surveyed May 22, 1972, by R. Q. MURPHY