


T.2S. R.3E. W.M.

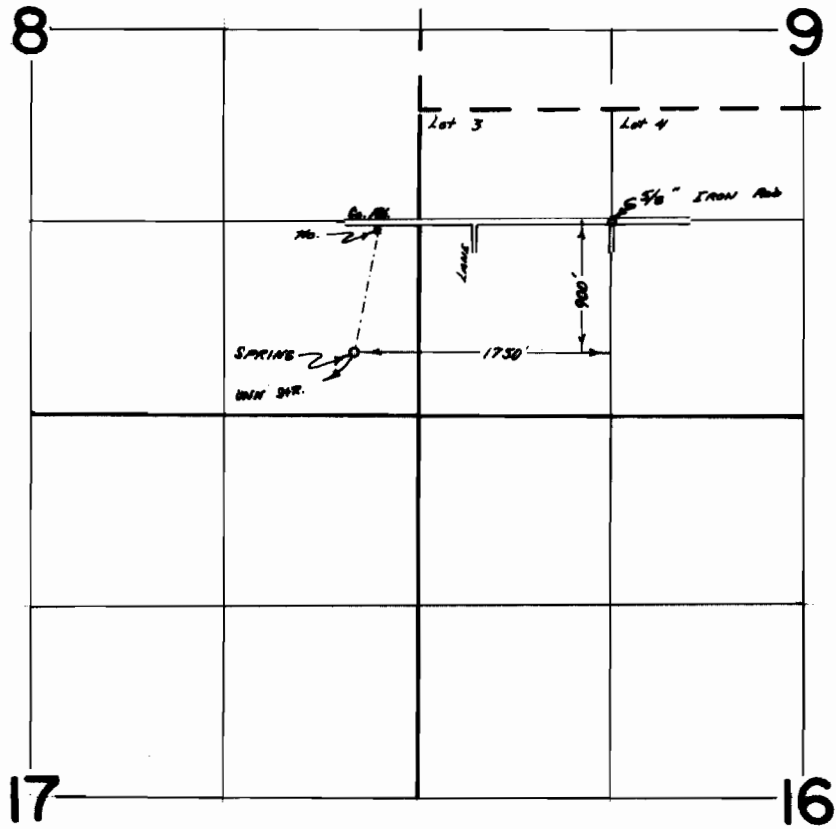

FINAL PROOF SURVEY
UNDER

Application No. 17219 Permit No. 3537
IN NAME OF

ESTATE OF KERMIT Q. LEAR

Surveyed SEP 15 1972, by R. E. MUGGERY