


T.15S.,R.4W.,W.M.

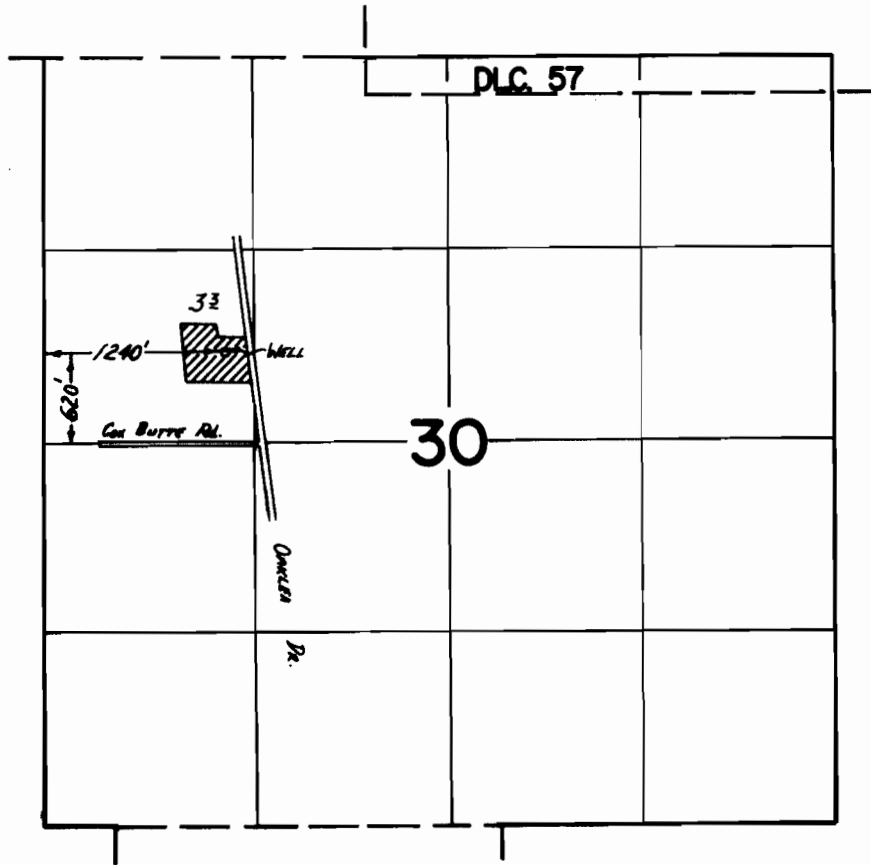

FINAL PROOF SURVEY
UNDER

Application No. G-4993 Permit No. G-4711
IN NAME OF

THOMAS CLOVIS BUCHANAN

Surveyed 25 Sept. 1972, by D. NORBY