


T.16S., R.5W., W.M.

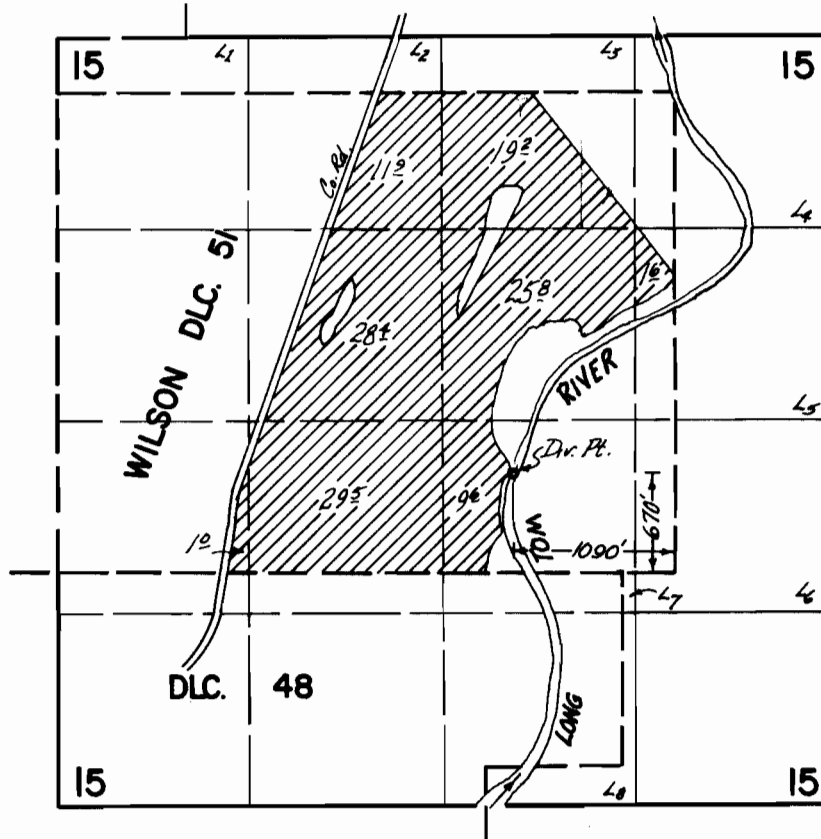

FINAL PROOF SURVEY UNDER

Application No. 42015 Permit No. 31443
IN NAME OF

W. LYNN & ETHELMA A. BARNES

Surveyed 27 Sept. 1972, by D. NORBY