



T.19S. R.2W. W.M.

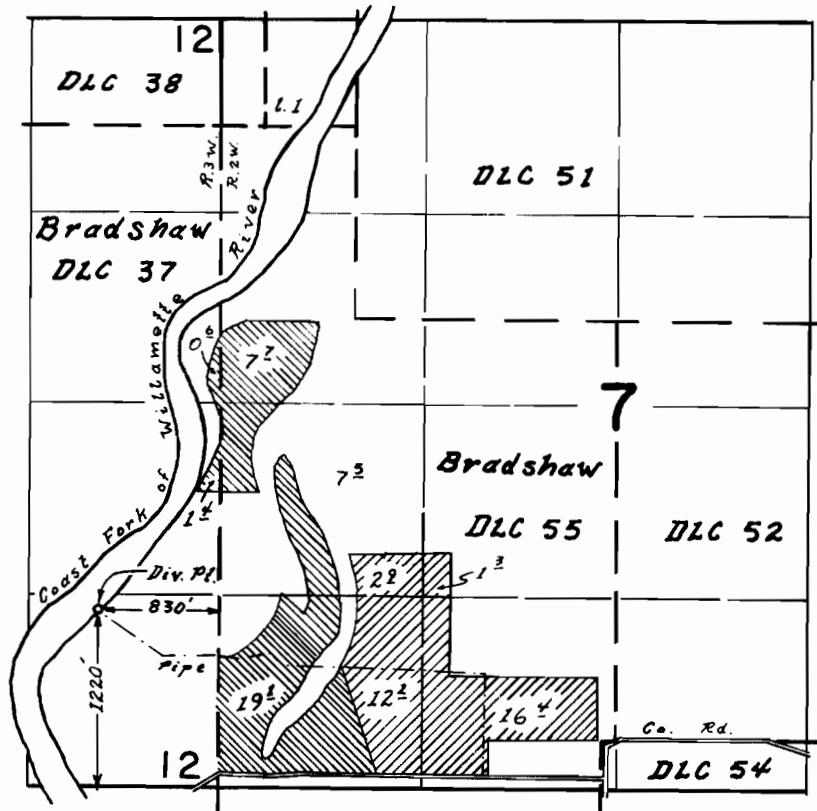

primary 
Supplemental 

FINAL PROOF SURVEY
UNDER

Application N 44851 Permit No. 33120
IN NAME OF

David Chilen

Surveyed 27 May 1972, by L.E. Gould