


T.16S., R.6W., W.M.

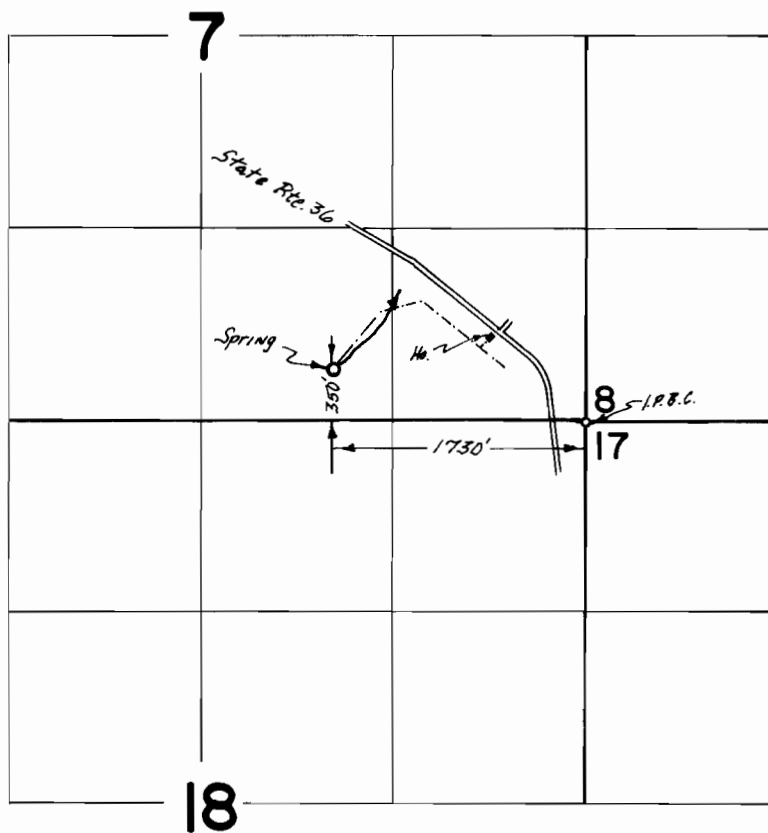

FINAL PROOF SURVEY
UNDER

Application No. 46943 Permit No. 34727
IN NAME OF

GILBERT H. & MAXINE L. MOADE

Surveyed 28 Sept. 19 72, by D. NORBY