


T.16S., R.5W., W.M.

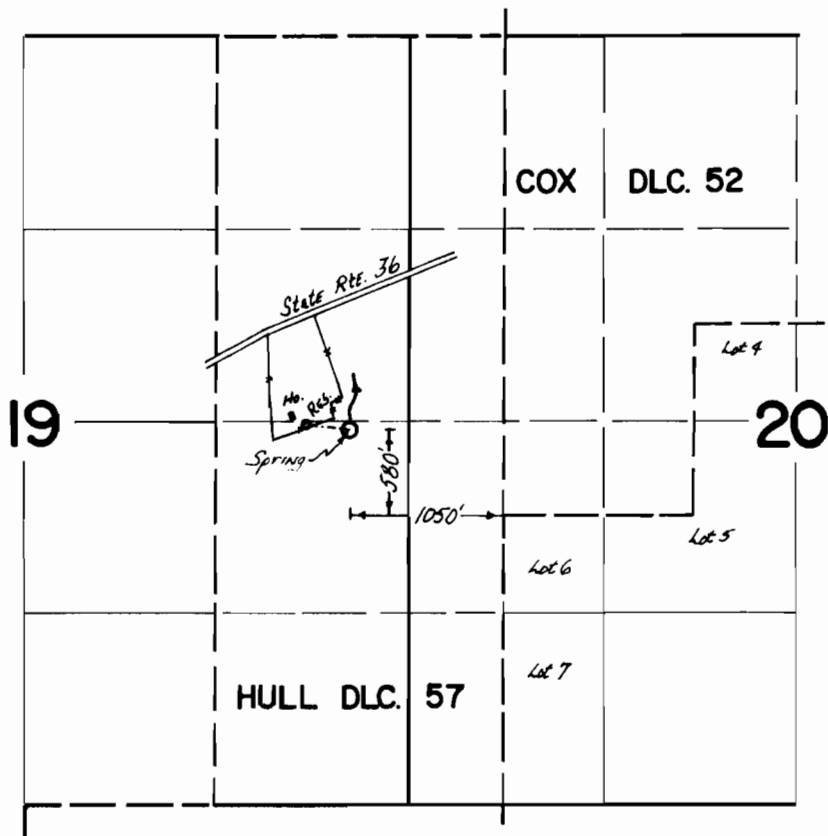

FINAL PROOF SURVEY
UNDER

Application No. 46534 Permit No. 34766
IN NAME OF

GORDON W. BREWER

Surveyed 28 Sept. 1972 by D. NORBY