


T.12S.R.IW.W.M.

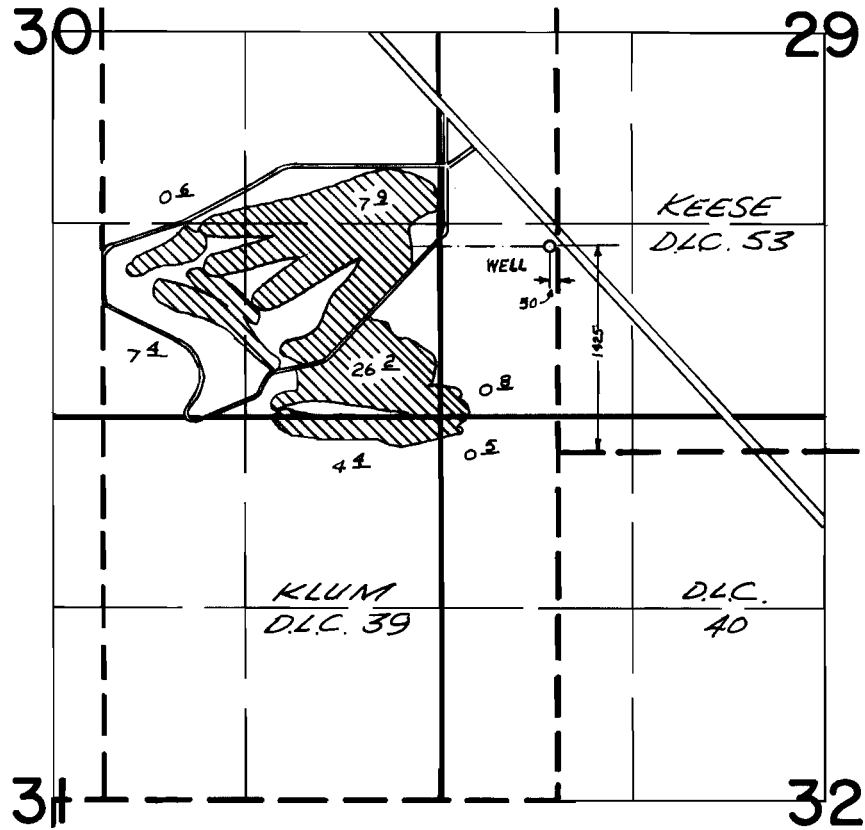

FINAL PROOF SURVEY UNDER

Application No. G-2951 Permit No. G-3253
IN NAME OF

GERLITA & ASSOCIATES INC.

Surveyed MAY 24 1972, by D. BUELL