


T.19S. R.3W. W.M.:

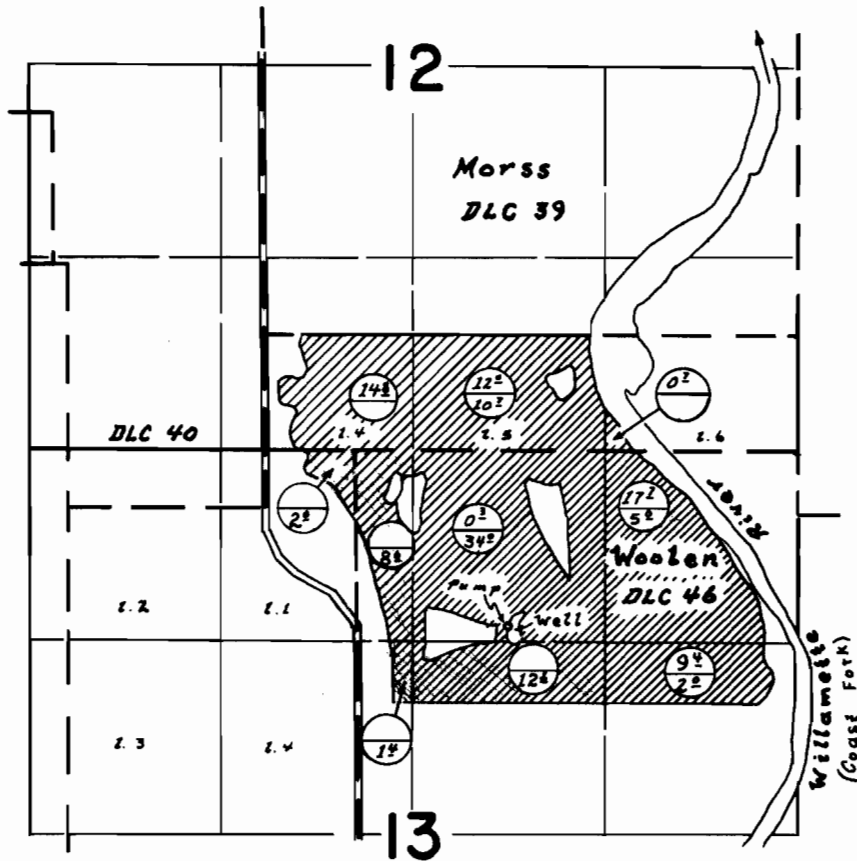

Well loc. 2000' S. & 1725' E. from SW. cor. Morss D.L.C. 39

FINAL PROOF SURVEY
UNDER

Application No. G-4573 Permit No. G-4344
IN NAME OF

PETER MURPHY

Surveyed 30 May. 1972, by L.E. Gould

Primary
Supplemental