


T.9S.R.1&2W.W.M.

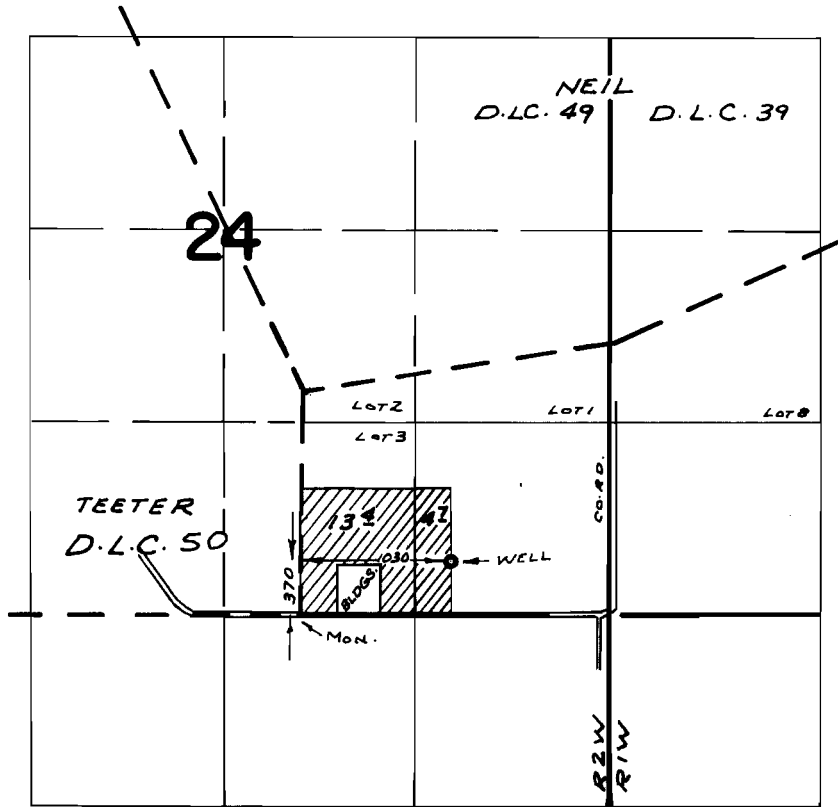

FINAL PROOF SURVEY UNDER

Application No. G-4287 Permit No. G-4036
IN NAME OF

HOFMANN BROS.

Surveyed OCT. 26, 1972, by R. MUCKEN