


T.9S.R.1E.W.M.

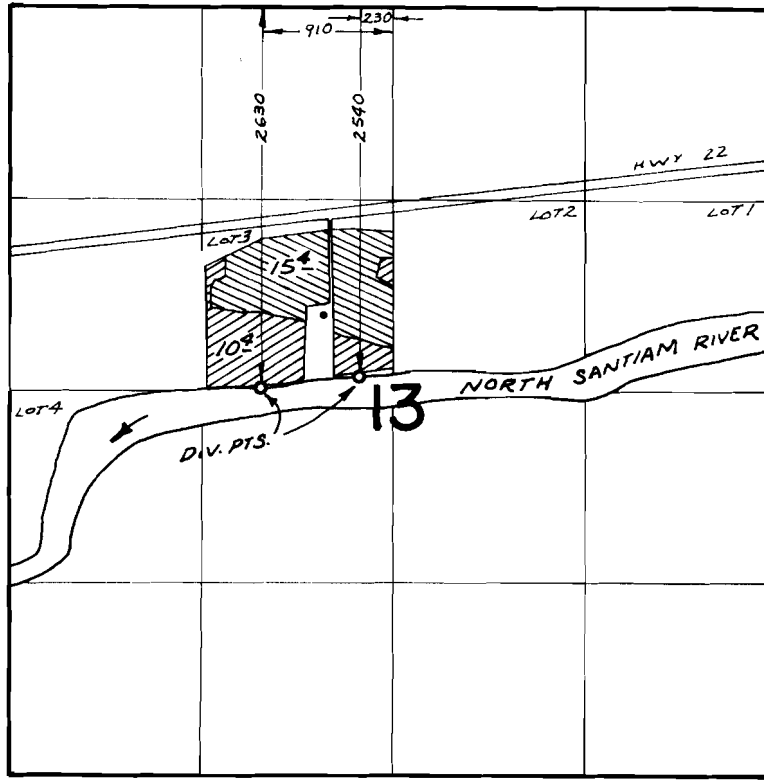

FINAL PROOF SURVEY UNDER

TRANSFER No. S-212
Application No. 45721 Permit No. 34107
IN NAME OF

JACK L. E. DELLA STURTEVANT

Surveyed JULY 28, 1972, by R. MUCKEN