


T.9S. R.6W. W.M.

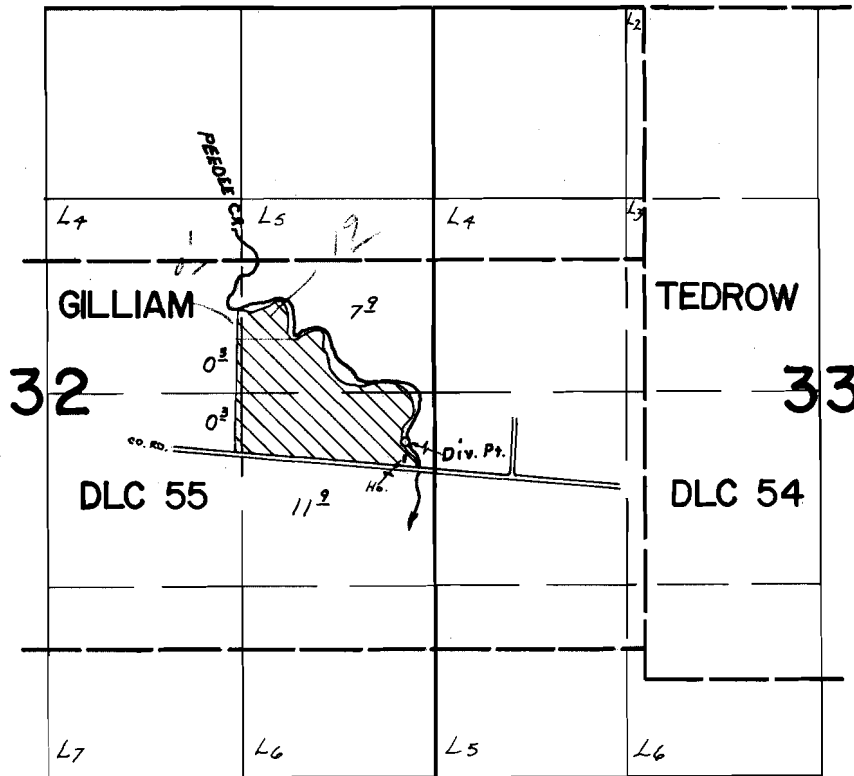

Div. Pt. Loc: 1250' S. & 1650' W. from NE cor. Gilliam DLC 55

FINAL PROOF SURVEY UNDER

Application No. 43613 Permit No. 32151
IN NAME OF

ROBERT V. FORD

Surveyed MARCH 28, 1973, by R. MUCKEN