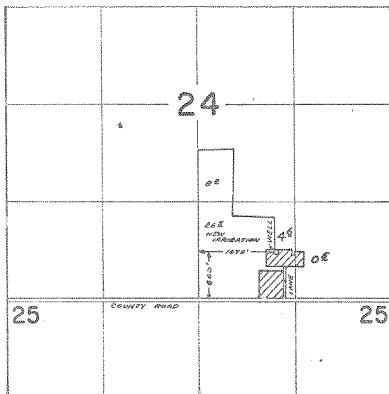


T. 3N.R. 33E.W.M.

Application No. G6636

Permit No. G 6205

FINAL PROOF SURVEY
UNDERApplication No. G-1037 Permit No. G-1147

IN NAME OF

PENDLETON BRANCH EXPERIMENT STA.
OREGON STATE UNIVERSITYSurveyed APR. 10 1973, by D.M. HARRIS

Field Copy