


G-2798

40891

T.3N.R.34E.W.M.

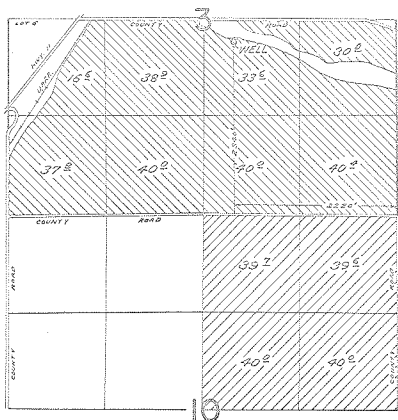

 PER. G-2798
  PER. G-3770

FINAL PROOF SURVEY UNDER

Application No. G-3003 Permit No. G-2798
G-4020 G-3770
 IN NAME OF

LIEVALLEN RANCH, INC.

Surveyed Apr. 18 1973 by D.M. Nord