


G-2990
40892

T.2N.R.33E.W.M.

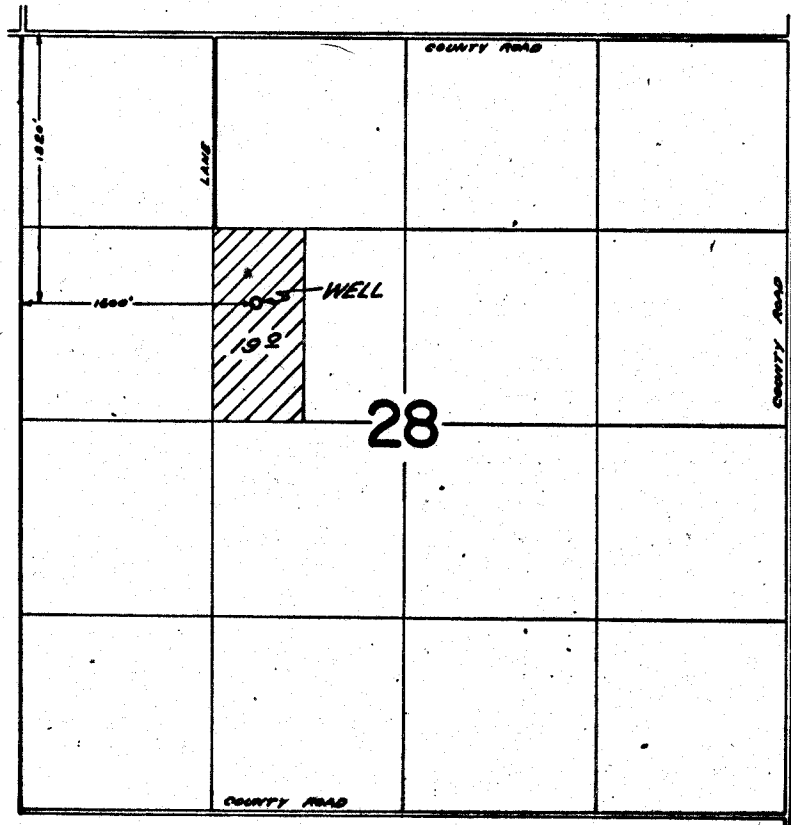

FINAL PROOF SURVEY UNDER

Application No. G-3104 Permit No. G-2990
IN NAME OF

DALE TUCKER

Surveyed Apr. 17 1973, by D.M. Norsy