
## T. 2 N.R. 32 E.W.M.

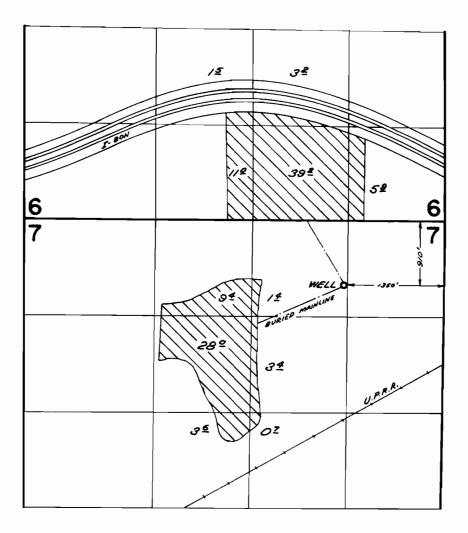

## FINAL PROOF SURVEY

Application No. <u>G-324/</u> Permit No. <u>G-3044</u> IN NAME OF
O. JAY BROSOITTI
Surveyed Apr. 16 19 73 by D.M.Noner