


G-3251
40894

T.4N.R.34E.W.M.

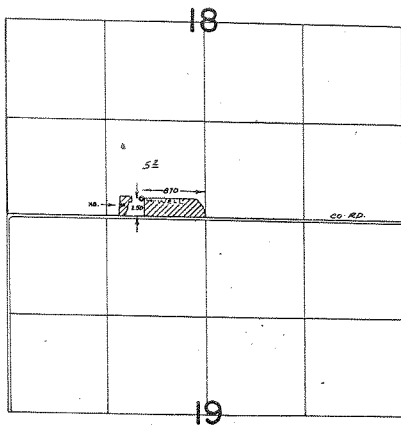

FINAL PROOF SURVEY
UNDER

Application No. G-3202 Permit No. G-3251
IN NAME OF

S. E. BROGGIATTI

Surveyed APR. 19, 1973 by R. MUGGEN