


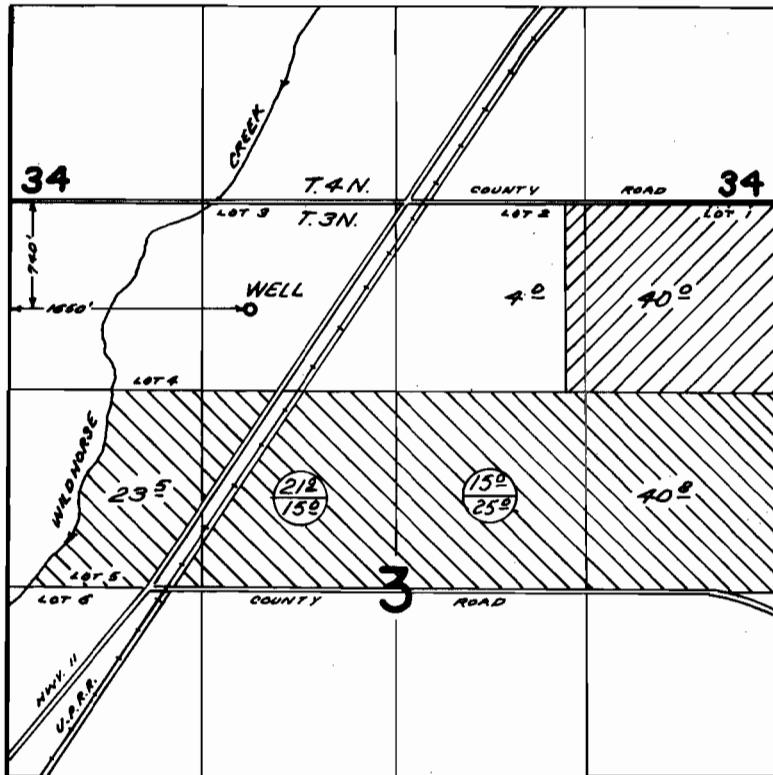


T.38&4N.R.34E.W.M.



 PER G-3279
  PRIMARY
 SUPPLEMENTAL
  PER G-3278

FINAL PROOF SURVEY UNDER

Application No. G-3477 Permit No. G-3278
 G-3478 G-3279
 IN NAME OF

B.L. DAVIS RANCH, INC.

Surveyed Apr. 10 1973, by D.M. NORBY