


G-3311
40897

T.4N. R.35E. W.M.

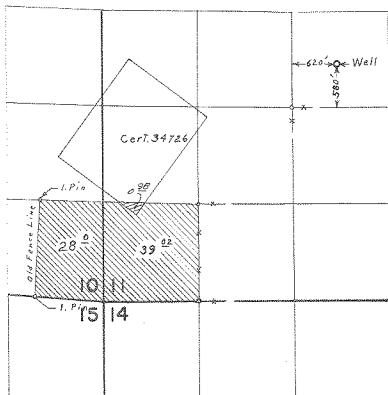

 primary

 Supplemental

FINAL PROOF SURVEY
UNDER

Application No. G-3519 Permit No. G-3311
IN NAME OF

BOB WINN

Surveyed Aug. 7, 1973, by L. E. Gould