


G - 3600
40899

T.4 N.R.34 E.W.M.

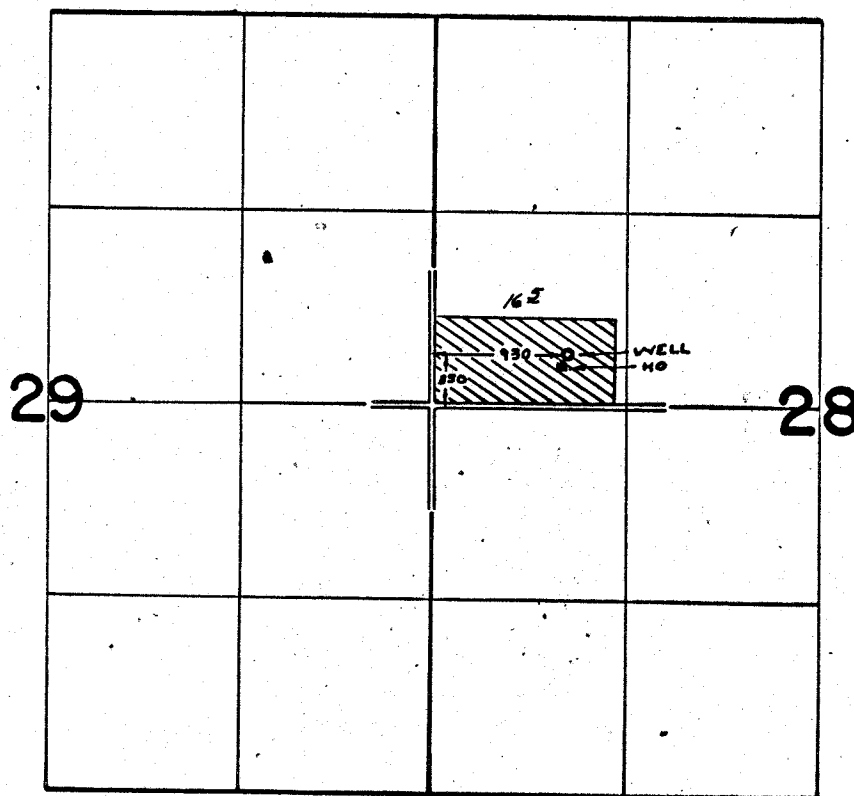

FINAL PROOF SURVEY UNDER

Application No. G-3017. Permit No. G-3600.
IN NAME OF

G. L. WOODWARD OREGON RANCH

Surveyed APR. 18, 1913, by R. MUGGEN.