


G-3770  
40900

T.3N.R.34E.W.M.

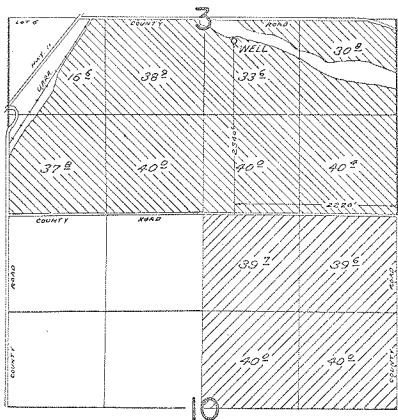

 PER. 6-2798  PER. 6-3770

FINAL PROOF SURVEY  
UNDER

Application No. 6-3003 Permit No. 6-2798  
6-4020 6-3770  
IN NAME OF

LIEVALLEN RANCH, INC.

Surveyed Apr. 18 1973, by D.M. Norsey