


T.6N.R.36E.W.M.

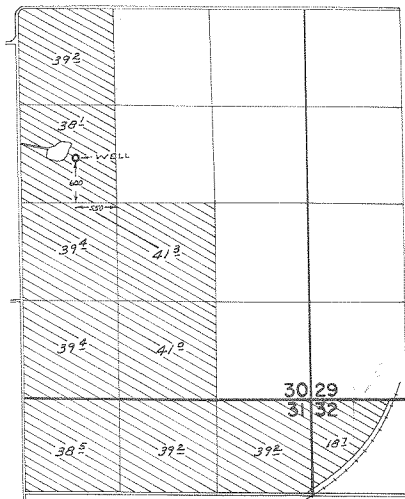

FINAL PROOF SURVEY
UNDER

Application No. G-4052, Permit No. G-3800
IN NAME OF
JAMES R. BAILEY for MAURINE
WILLIAMS, MARY LEE FARLEY & GLADYS BAILEY

Surveyed APR. 16, 1973, by R. MUGGEN