


G-4062
40903

T.4N.R.34&35E.W.M.

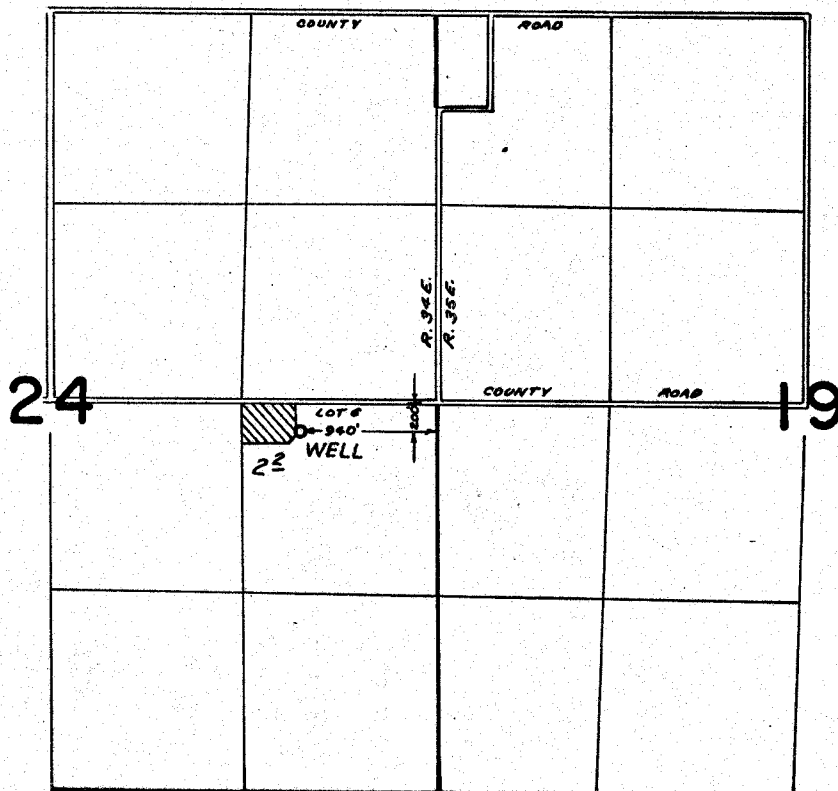

FINAL PROOF SURVEY UNDER

Application No. G-4301 Permit No. G-4062
IN NAME OF

LAWRENCE BEAMER

Surveyed Apr. 17 1973, by R. G. MUCKEN