


6-4142

40904

# T.6N.R.35E.W.M.

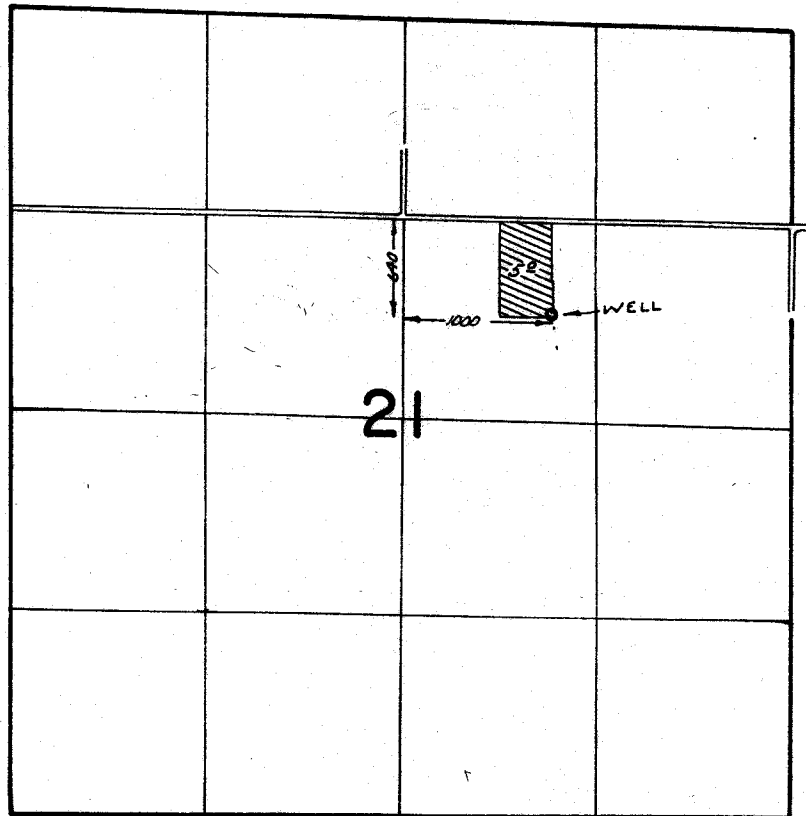

## FINAL PROOF SURVEY UNDER

Application No. G-4374 Permit No. G-4142  
IN NAME OF

HARRY CHAKOS

Surveyed APR. 10, 1973, by R. MUCKEN