


6-4195

40905

T.6N. R.35&36E. W.M.

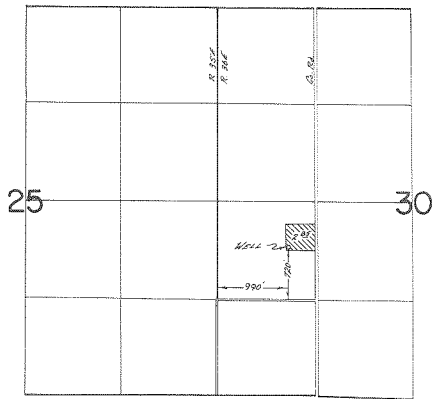

FINAL PROOF SURVEY UNDER

Application No. 8-4450 Permit No. 6-4195
IN NAME OF

ERNIE B. JOHNSON

Surveyed APRIL 12, 1973, by R. G. MURKIN