


G-4279
40906

T.4N.R.34E.W.M.

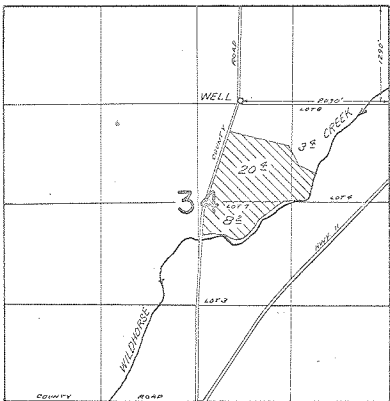

FINAL PROOF SURVEY
UNDER

Application No. G-4555 Permit No. G-4279
IN NAME OF

DAVIS RANCH, INC.

Surveyed Apr. 10 1973, by D.M. Nordy