



T. 38 & 4 N. R. 34 E. W.M.

G-4311
40912

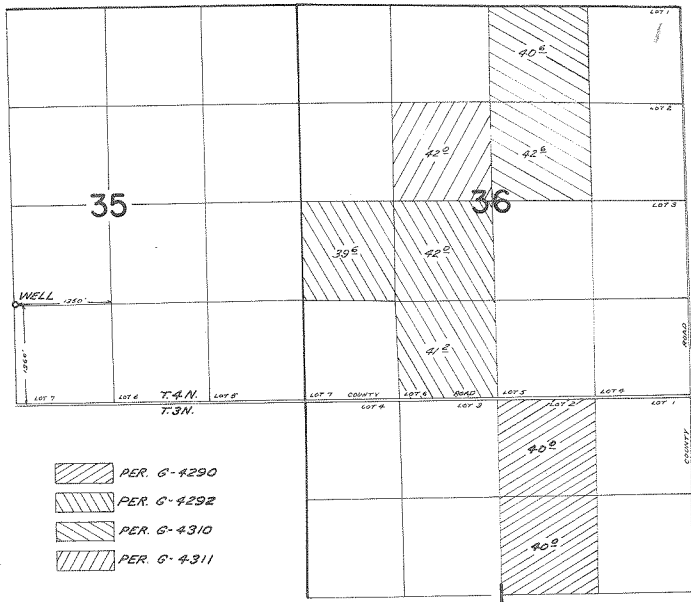

-  PER. G-4290
-  PER. G-4292
-  PER. G-4310
-  PER. G-4311

**FINAL PROOF SURVEY
UNDER**

G-4556 G-4290
G-4558 G-4292
G-4580 G-4310
G-4582 Permit No. G-4311

Application No. G-4582 Permit No. G-4311

IN NAME OF

B.L. DAVIS RANCH, INC.

Surveyed APR 10 1973, by D.M. NORBY