





G-4314  
40914

# T. 4N.R. 34E.W.M.

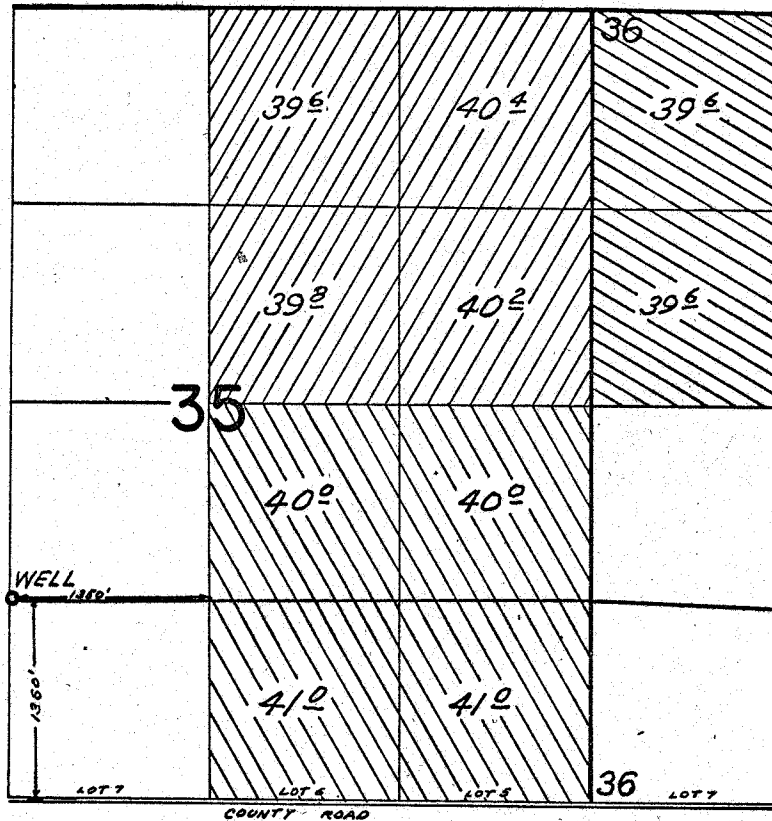

 PER. G-4297  PER. G-4313  PER. 4314
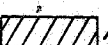
## FINAL PROOF SURVEY UNDER

Application No. G-4574 Permit No. G-4297  
G-4585 G-4313  
G-4587 G-4314

IN NAME OF

B. L. DAVIS RANCH, INC.

Surveyed Apr. 10 1923, by D. M. NORBY