


T. 38 & 4 N. R. 34 E. W. M.

G-4311  
40912

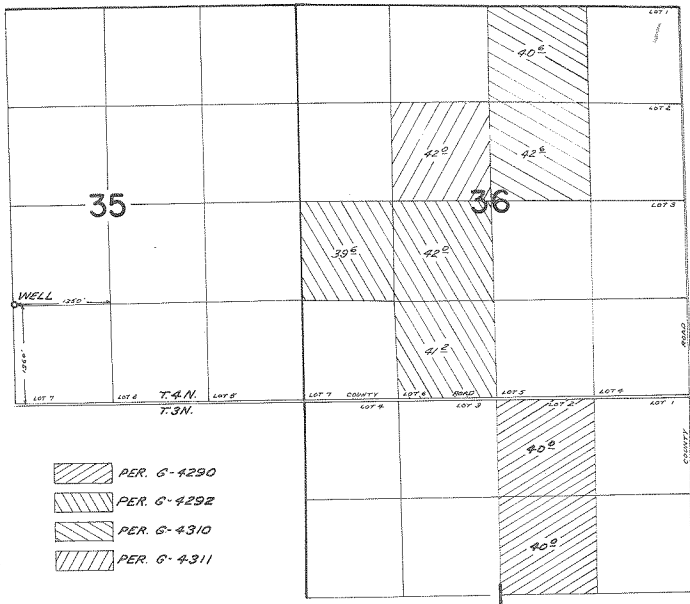

-  PER. G-4290
-  PER. G-4292
-  PER. G-4310
-  PER. G-4311

**FINAL PROOF SURVEY**  
UNDER

G-4556                  G-4290  
G-4558                  G-4292  
G-4580                  G-4310  
G-4582                  G-4311

Application No. G-4582 Permit No. G-4311  
IN NAME OF

B.L. DAVIS RANCH, INC.

Surveyed APR 10 1973, by D.M. NORBY