


G-4317
40915

T.2N.R.33E.W.M.

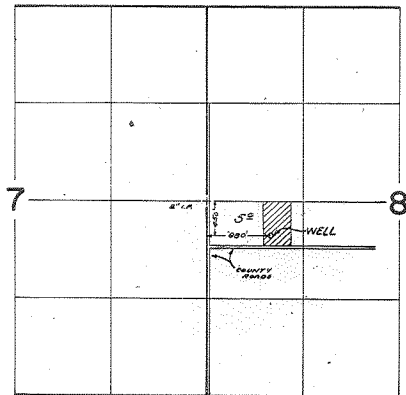

FINAL PROOF SURVEY UNDER

Application No. G-4590 Permit No. G-4317

IN NAME OF

ESTATE OF ROY C. SMITH

Surveyed Apr. 17, 1979 by D.M. NORBY