


G-4358

40917

# T.6N.R.35E.W.M.

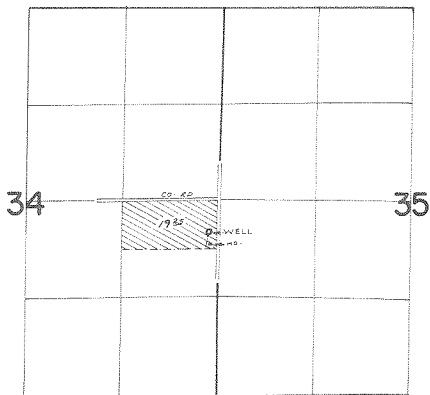

WELL LOC: 440'S & 140'W FROM E  $\frac{1}{2}$  COR. SEC. 34

## FINAL PROOF SURVEY UNDER

Application No. G-4634 Permit No. G-4358  
IN NAME OF

FRED S. GROTH

Surveyed APR. 11, 1973, by R. MUCKEN