


G-4385
40921

T. 2N. R. 33E. W.M.

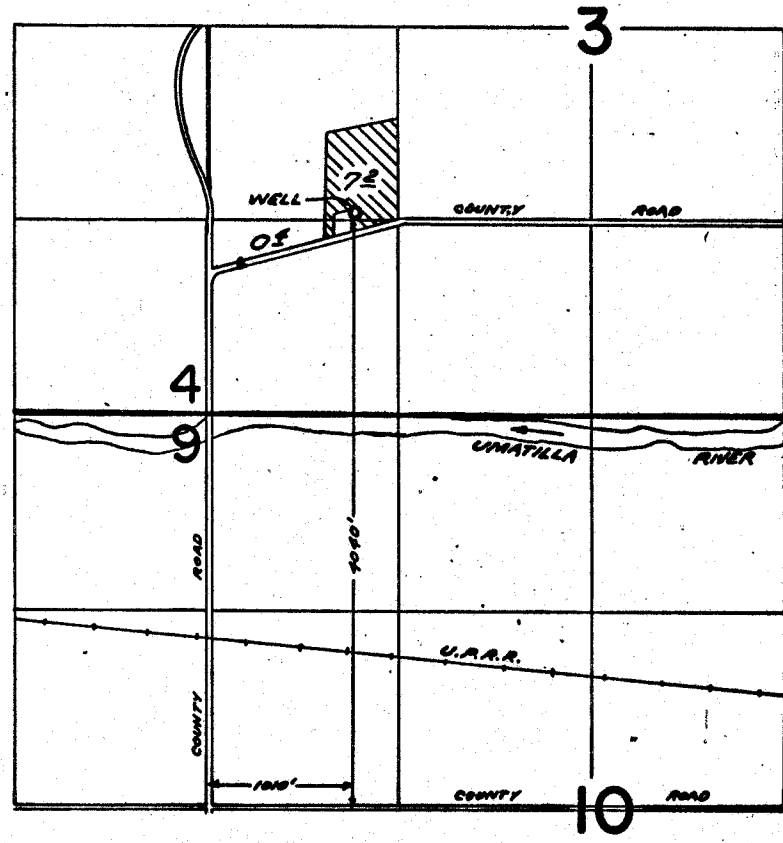

FINAL PROOF SURVEY UNDER

Application No. G-4661 Permit No. G-4385
IN NAME OF

WARREN J. WILKINSON

Surveyed Apr. 16 1973, by D.M. NORBY