


6-4388

43796
40922

T.6N. R.36E. W.M.

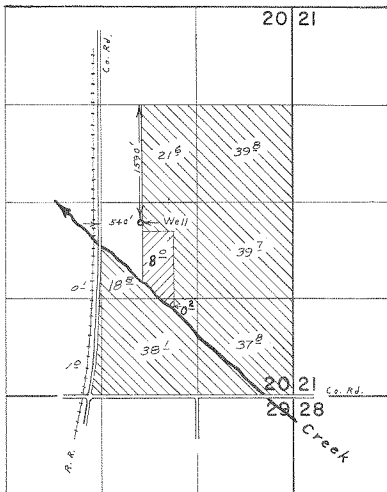

Primary
Supplemental



FINAL PROOF SURVEY
UNDER

Application No. G-4664 Permit No. G-4388
IN NAME OF

DONALD K. SMITH

Surveyed Aug. 9., 1973., by J. E. Gould.