


G-4469
50925
40926

T. 1N., R. 32E., W.M.

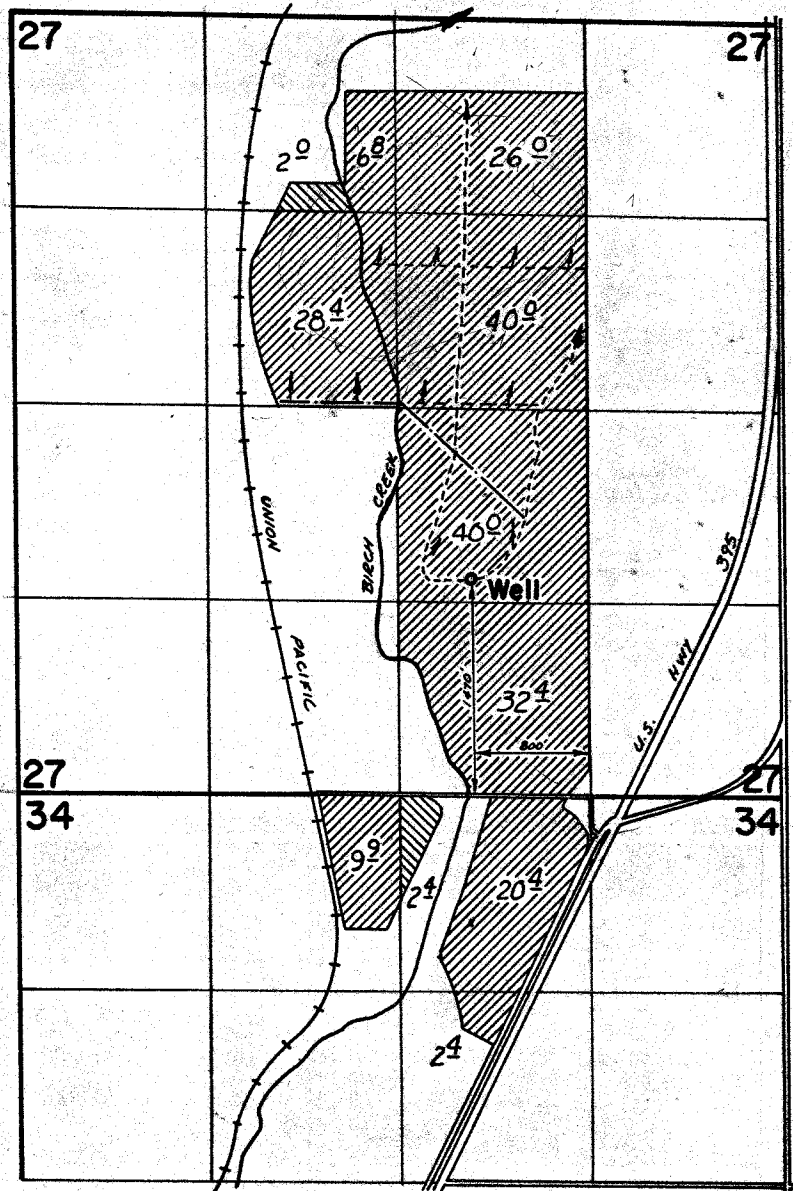

FINAL PROOF SURVEY UNDER

 PRIMARY
 SUPPLEMENTAL

Application No. G-4751 Permit No. G-4469
IN NAME OF

CLARENCE C. HOEFT

Surveyed April 13, 1973, by D. Norby