


G-4682
40930

T.4N.R.35E.W.M.

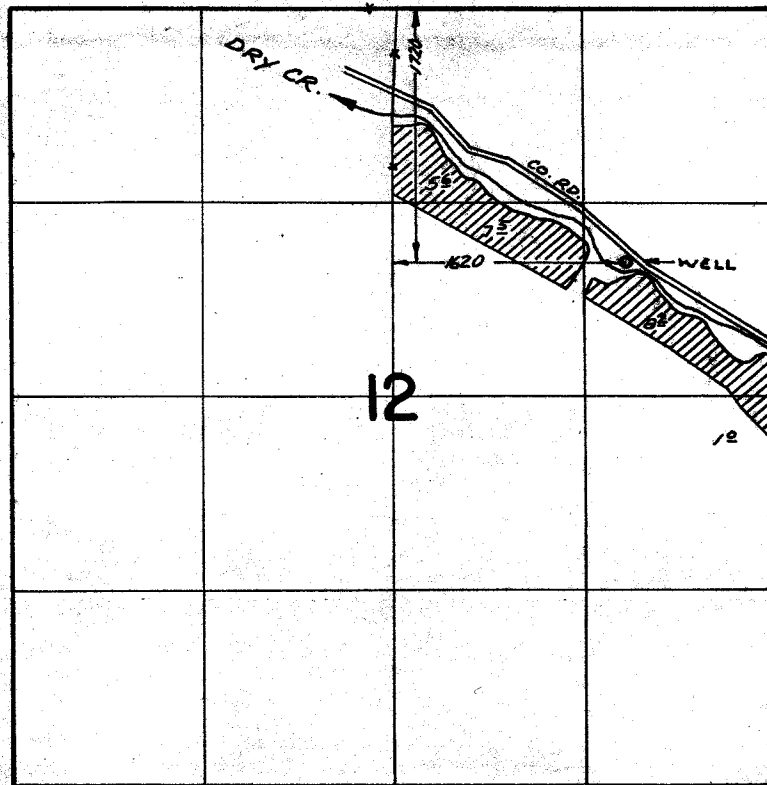

FINAL PROOF SURVEY
UNDER

Application No. G-4262 Permit No. G-4682
IN NAME OF

GEORGE C. LIEVALLEN

Surveyed APR. 19, 1973, by R. MUCKEN