


G-4881  
40932

T.4N.R.33E.W.M.

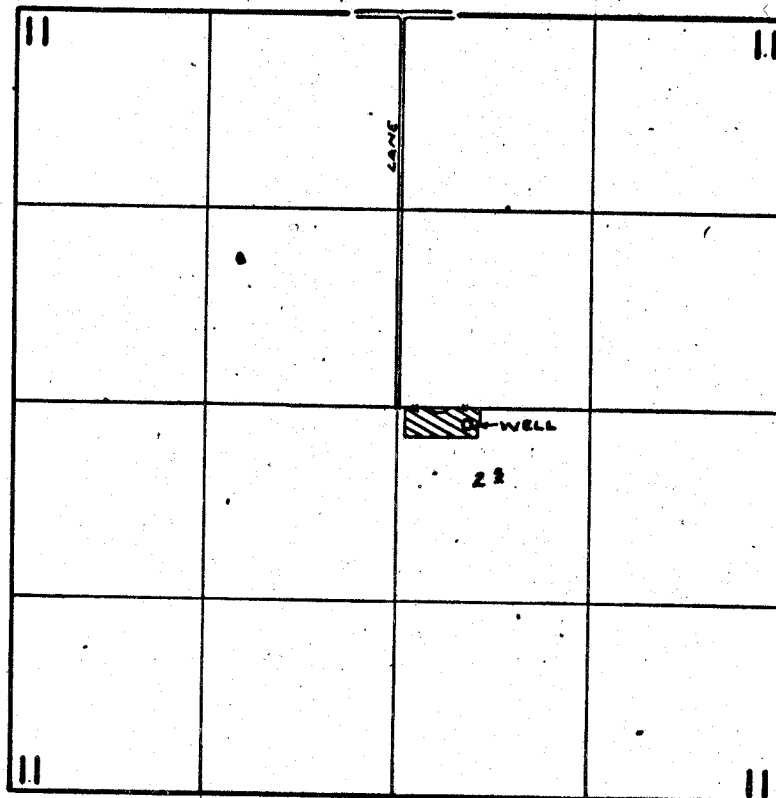

WELL LOC: 110'S & 480'E. FROM CEN. SEC. 11

**FINAL PROOF SURVEY**  
UNDER

Application No. G-5148 Permit No. G-4881  
IN NAME OF

HELIX...CEMETERY...MAINTENANCE DIST. NO. 4

Surveyed APR...12, 1923, by R. MUCKEN