


G-4951  
48933

T.6N.R.35E.W.M.

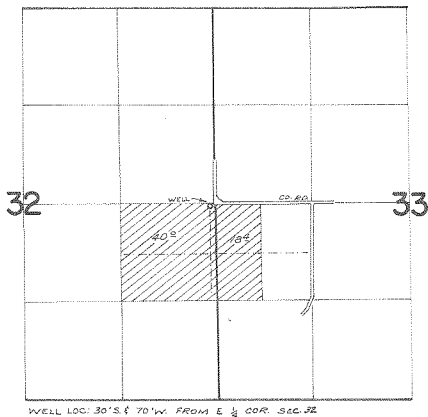

**FINAL PROOF SURVEY**  
UNDER

Application No. *G-5392* Permit No. *G-4951*  
IN NAME OF

*JOHN KELLY*

Surveyed *APR. 13, 1973*, by *R. MUCKEN*