


6-4977
40934

T.5N.&6N.R.35E.W.M.

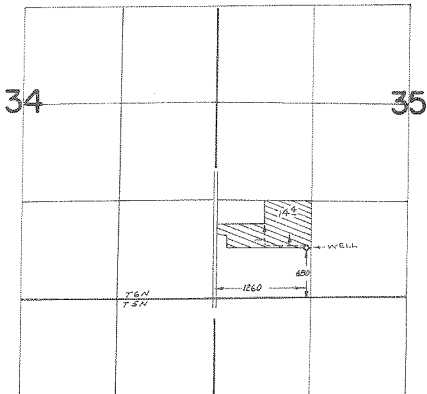

FINAL PROOF SURVEY UNDER

Application No. *G-4052* Permit No. *G-4977*
IN NAME OF

JAMES C. SMITH

Surveyed *APR. 11, 1973*, by *R. MURKEN*