


T. 4N.R. 35E.W.M.

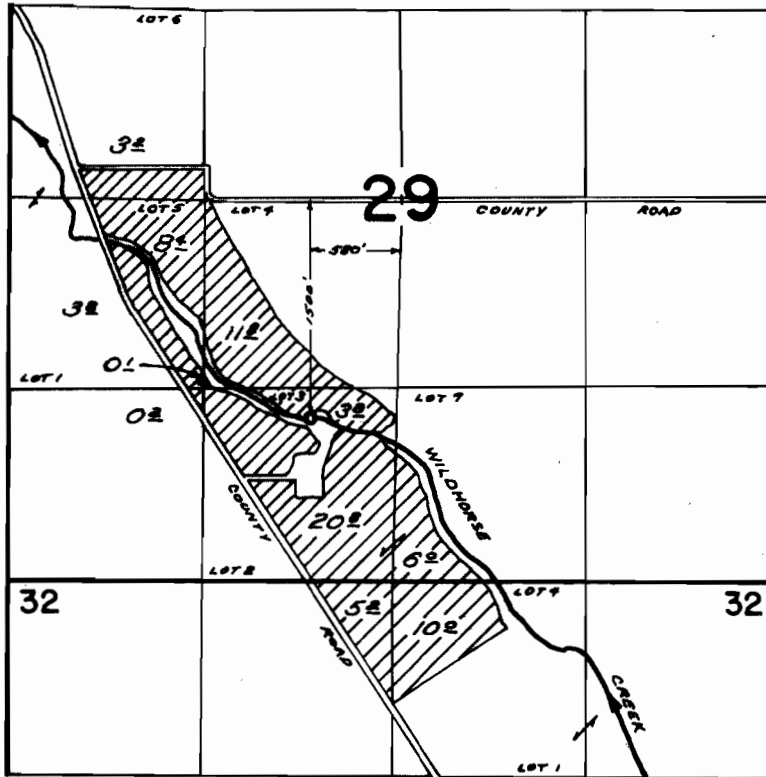

FINAL PROOF SURVEY UNDER

Application No. 42463 Permit No. 31394

IN NAME OF

THE OREGON BANK, TRUSTEE
% WALTER L. AVERY

Surveyed APR 14 1973, by R. G. MUCKEN