


T. 2 N. R. 32 E. W. M.

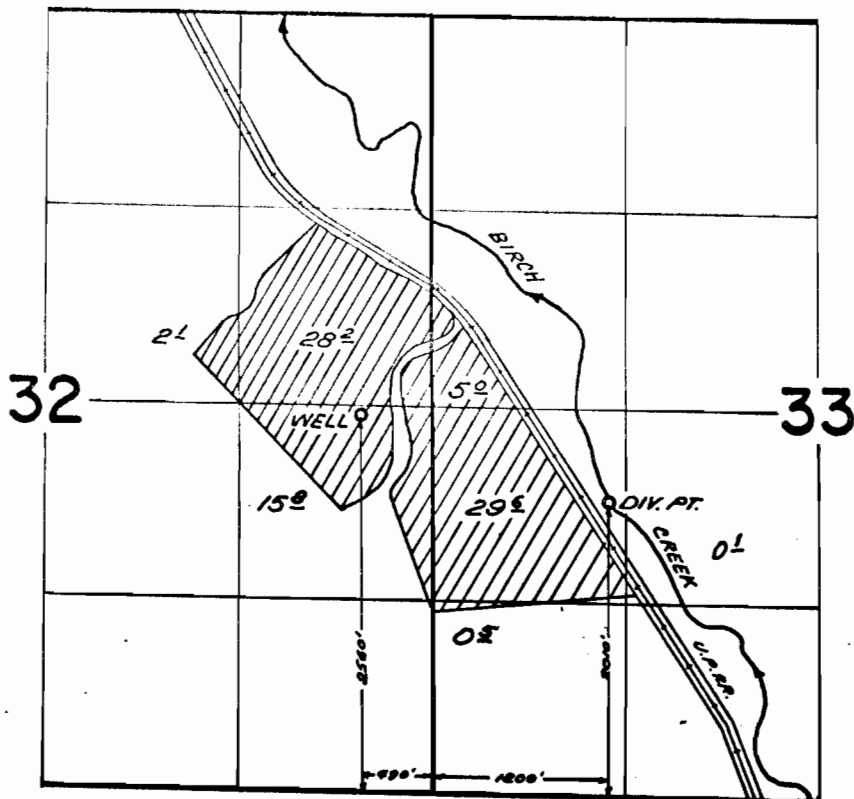

**FINAL PROOF SURVEY**  
UNDER

Application No. G-4395  
43008 Permit No. G-4143  
32132  
IN NAME OF

CHARLES A. PETERSON

Surveyed Apr. 13 1973, by D.M. Noney