


T.3N., R.34E., W.M.

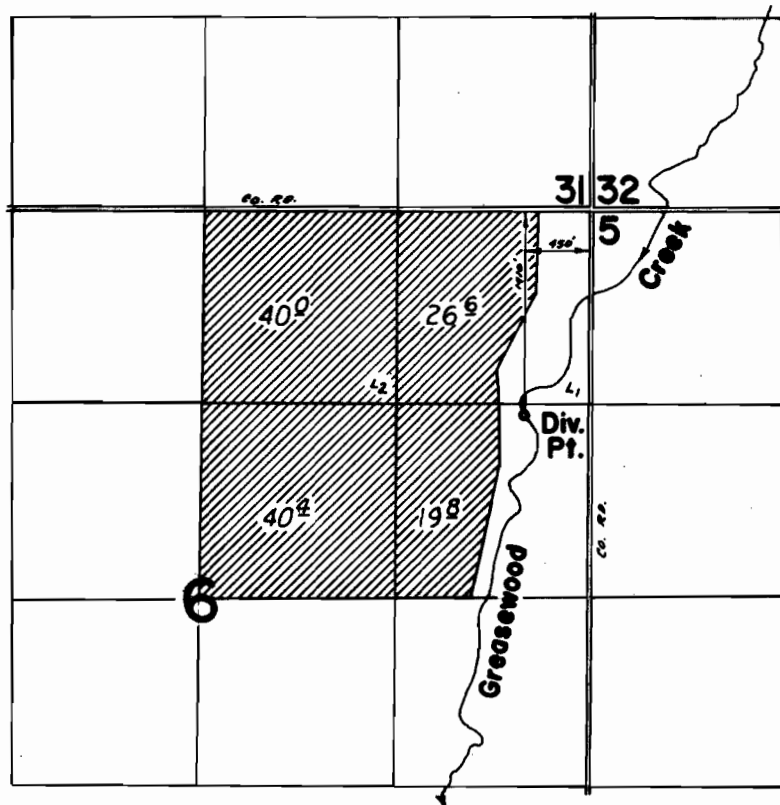

**FINAL PROOF SURVEY**  
UNDER

Application No. 43355 Permit No. 32404  
IN NAME OF

B. L. DAVIS RANCH, INC.

Surveyed April 10, 1973, by D. Norby