


T.5N. & 6N. R.35E.W.M.

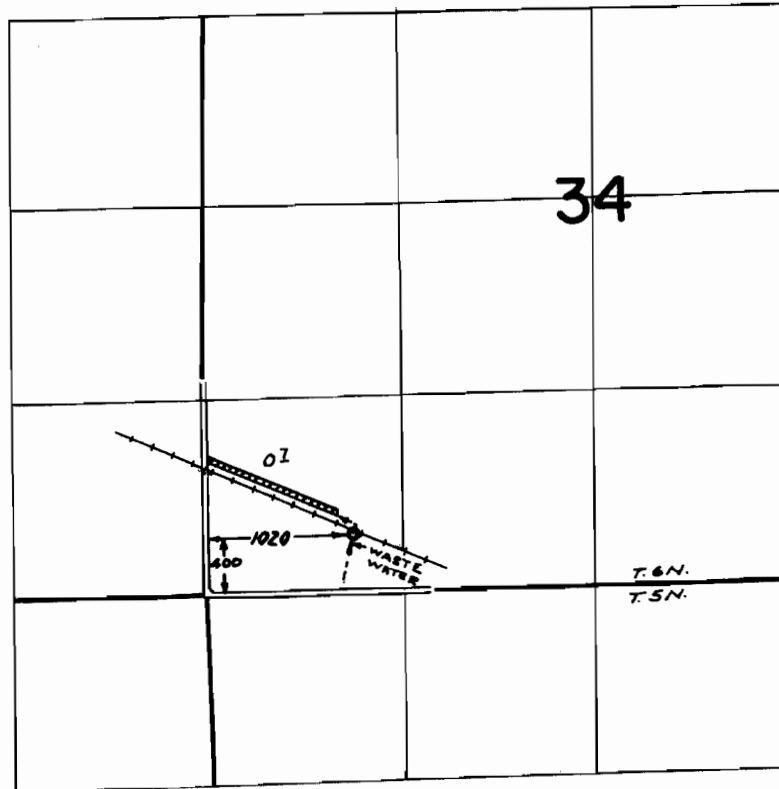

FINAL PROOF SURVEY
UNDER

Application No. 43438 Permit No. 32560
IN NAME OF

.....CHARLES J. NAGELE.....

Surveyed APR. 13, 1973, by R. MUCKEN