


T. 2 N. R. 32 E. W.M.

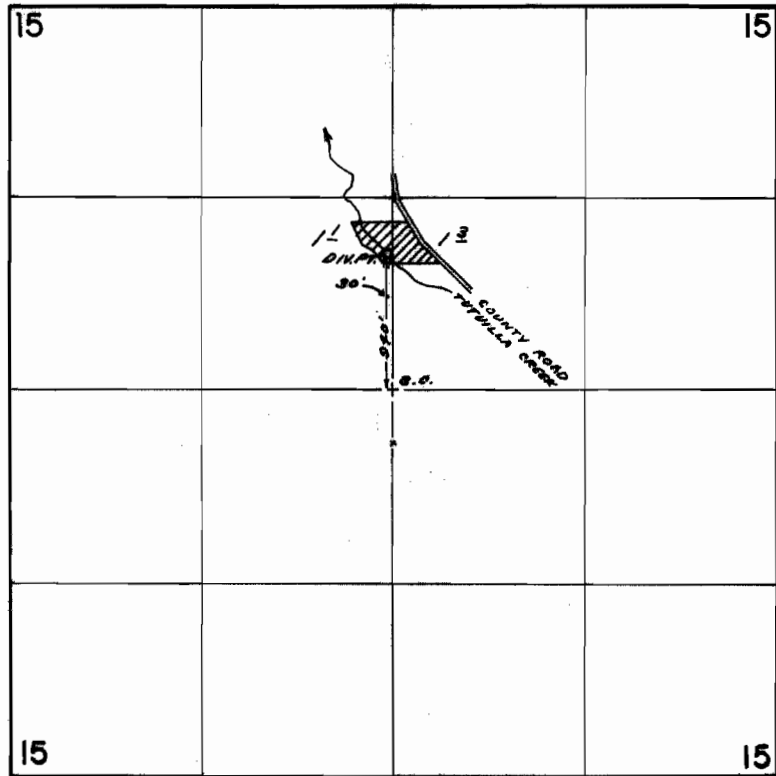

FINAL PROOF SURVEY UNDER

Application No. 43686 Permit No. 32653
IN NAME OF

DELBERT V. GRIFFIN

Surveyed Apr. 14 1973, by D. M. NORBY