


T.5N. R.29E. W.M.

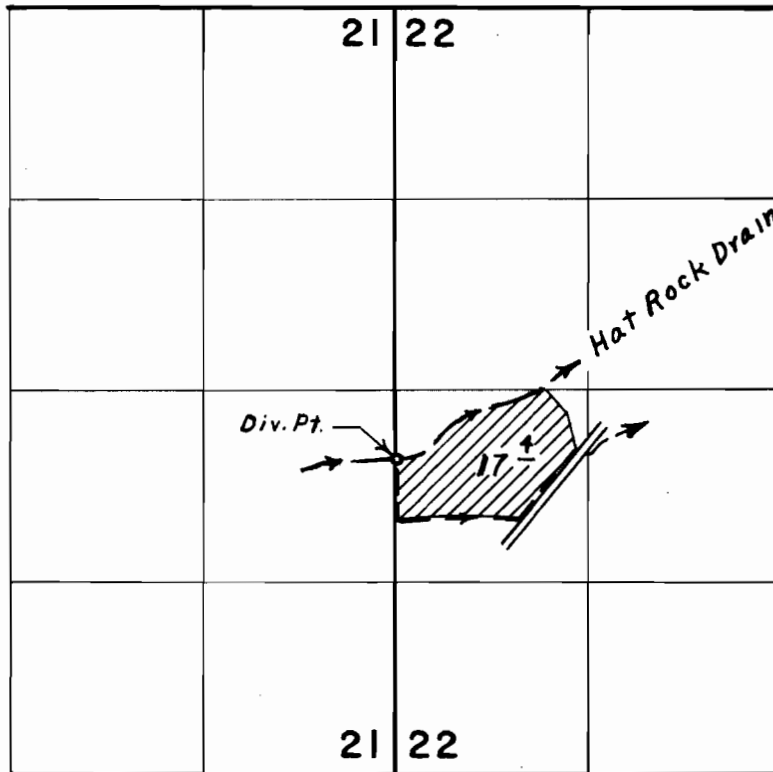

Div. Pt. located 2170' N. & 10' E. from S.W. Cor. Sec. 22

FINAL PROOF SURVEY
UNDER

Application No. 44219 Permit No. 33029
IN NAME OF

STEWART U. & GLORIA B. GUTHERY

Surveyed April 19, 1973, by L. E. Gould