


T.3N.R.34E.W.M.

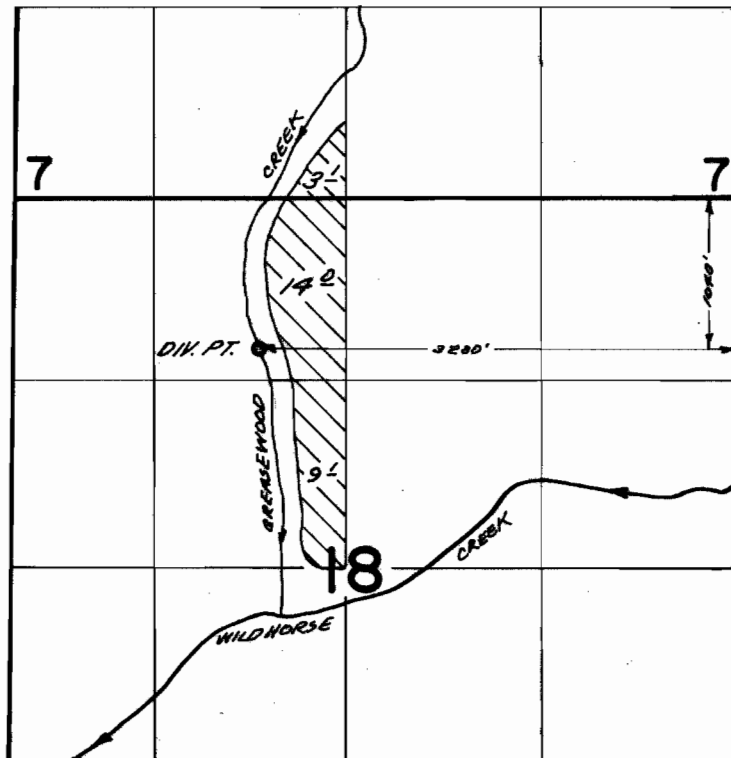

FINAL PROOF SURVEY
UNDER

Application No. 45018 Permit No. 33648
IN NAME OF

ROBERT H. ROTHROCK

Surveyed Apr. 13 1973, by D. H. NORBY