


T.3N. R.29E. W.M.

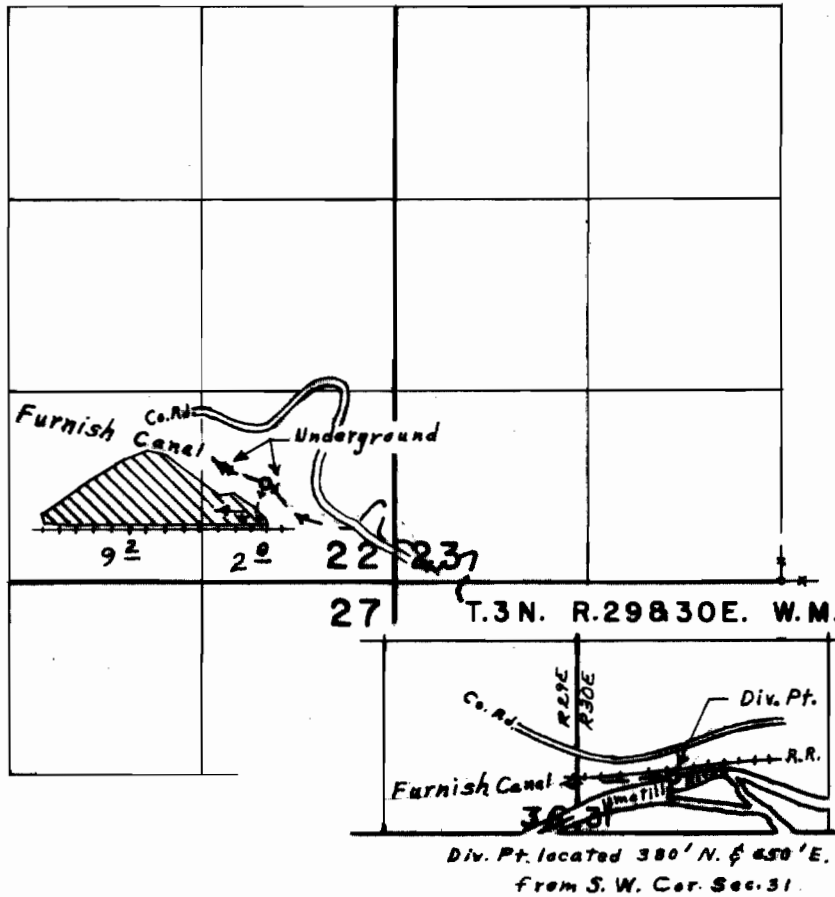

**FINAL PROOF SURVEY**  
UNDER

Application No. 45823.. Permit No. 34194..  
IN NAME OF

**JOSEPH G. RAMOS**

Surveyed April 12, 1973, by L. E. Gould.