


T. 2. N. R. 33 E. W. M.

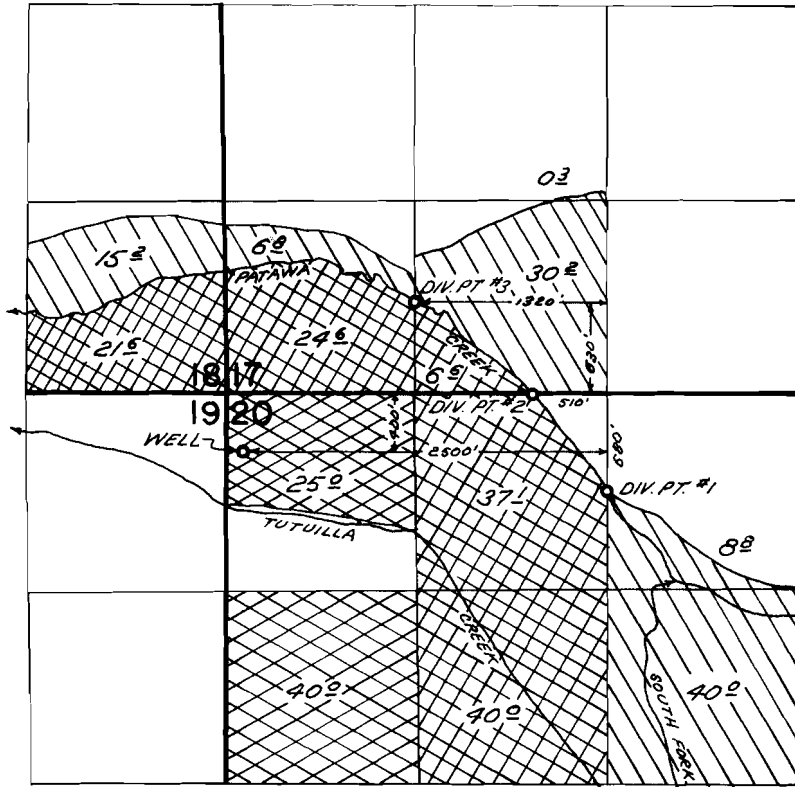

	PRIMARY	SUPPLEMENTAL
PERMIT 34360		
PERMIT 6-4300		

FINAL PROOF SURVEY UNDER

Application No. 46004 G-4577 Permit No. 34360 G-4300

IN NAME OF
DAVE UMBARGER
LOUIS UMBARGER

Surveyed Apr. 17 1973, by D. M. NORBY