


T.4S.,R.39E.,W.M.

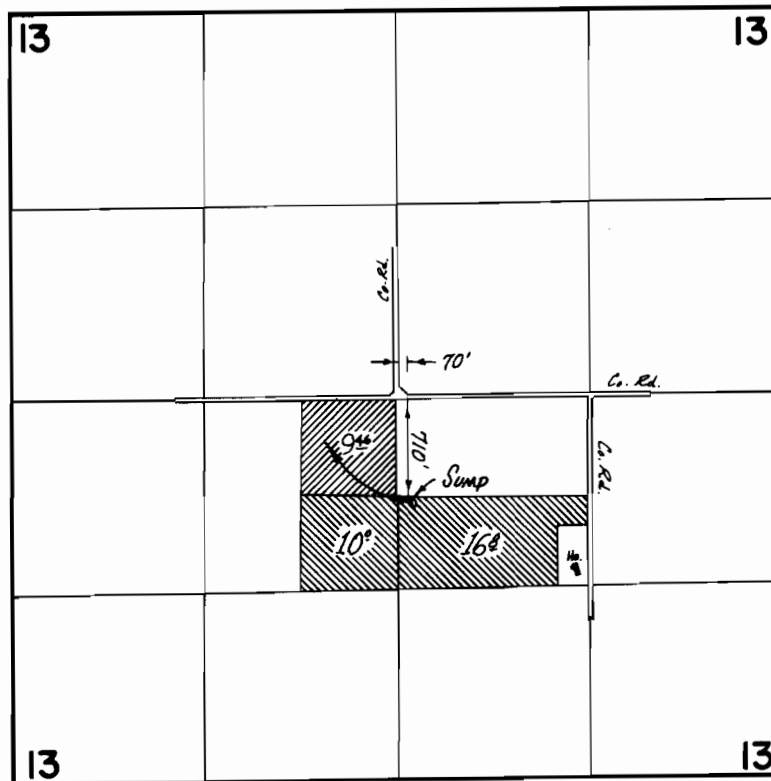

 primary
 Supplemental

FINAL PROOF SURVEY
UNDER

Application No. G-3591 Permit No. G-3379
IN NAME OF

CHARLIE & ALICE W. HIBBERT

Surveyed July 12 1973, by D. Norway