


T. 3 S., R. 39 E., W.M.

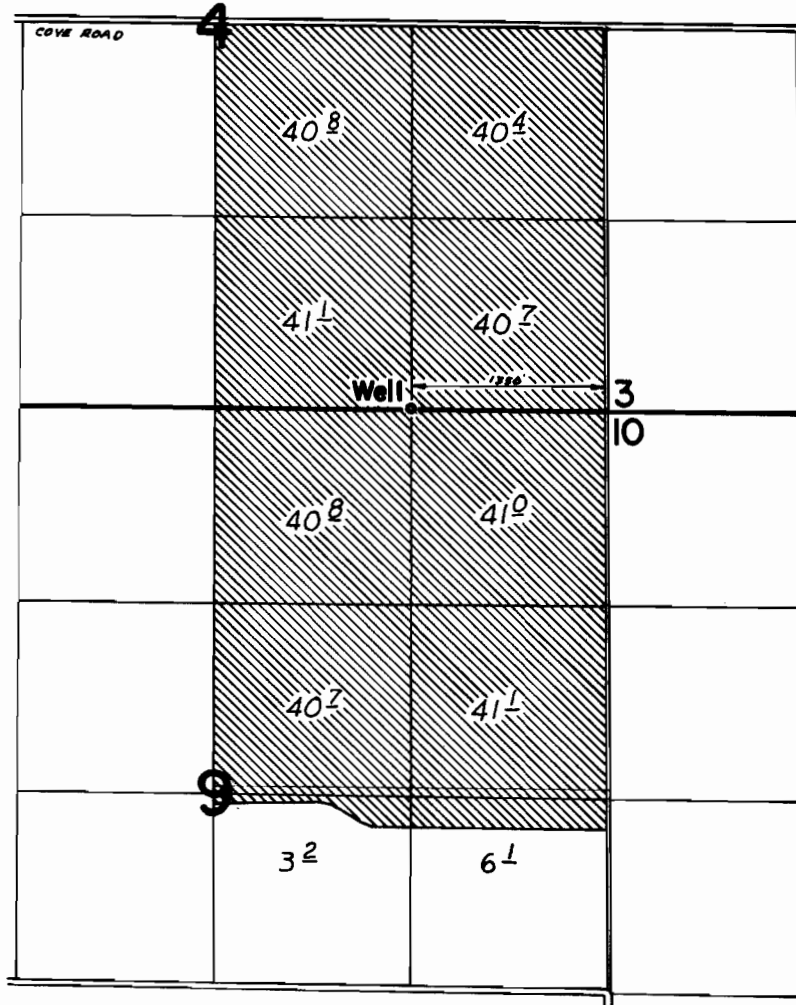

**FINAL PROOF SURVEY**  
UNDER

Application No. G-4813 Permit No. G-4509  
IN NAME OF

MERTON TAYLOR

Surveyed July 14 1973, by D. Norby