


T.3S.,R.38E.,W.M.

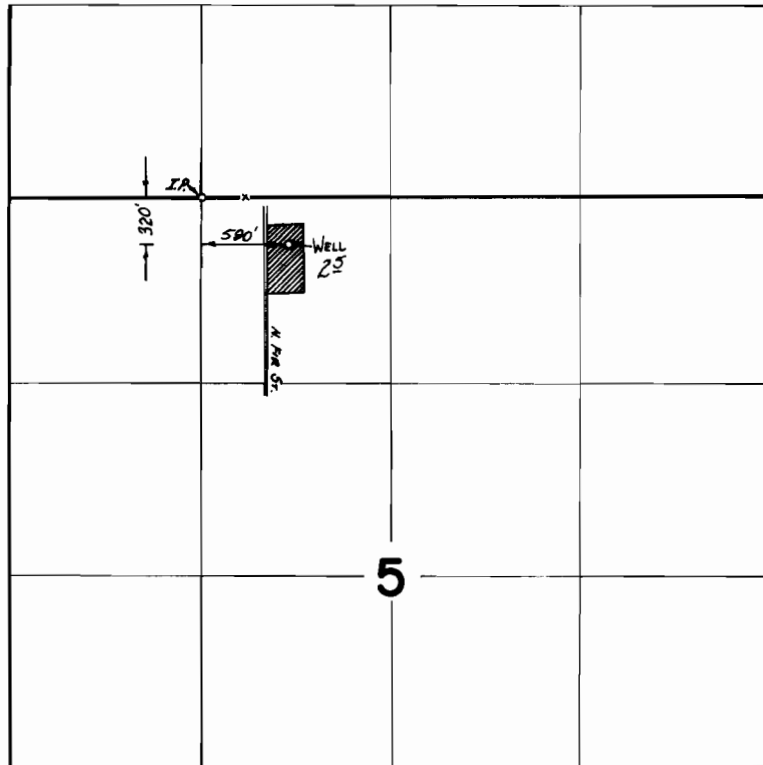

FINAL PROOF SURVEY
UNDER

Application No. G-4831 Permit No. G-4554
IN NAME OF

JOHN H. & BETTY E. RYAN

Surveyed July 10 1973, by D. NORBY